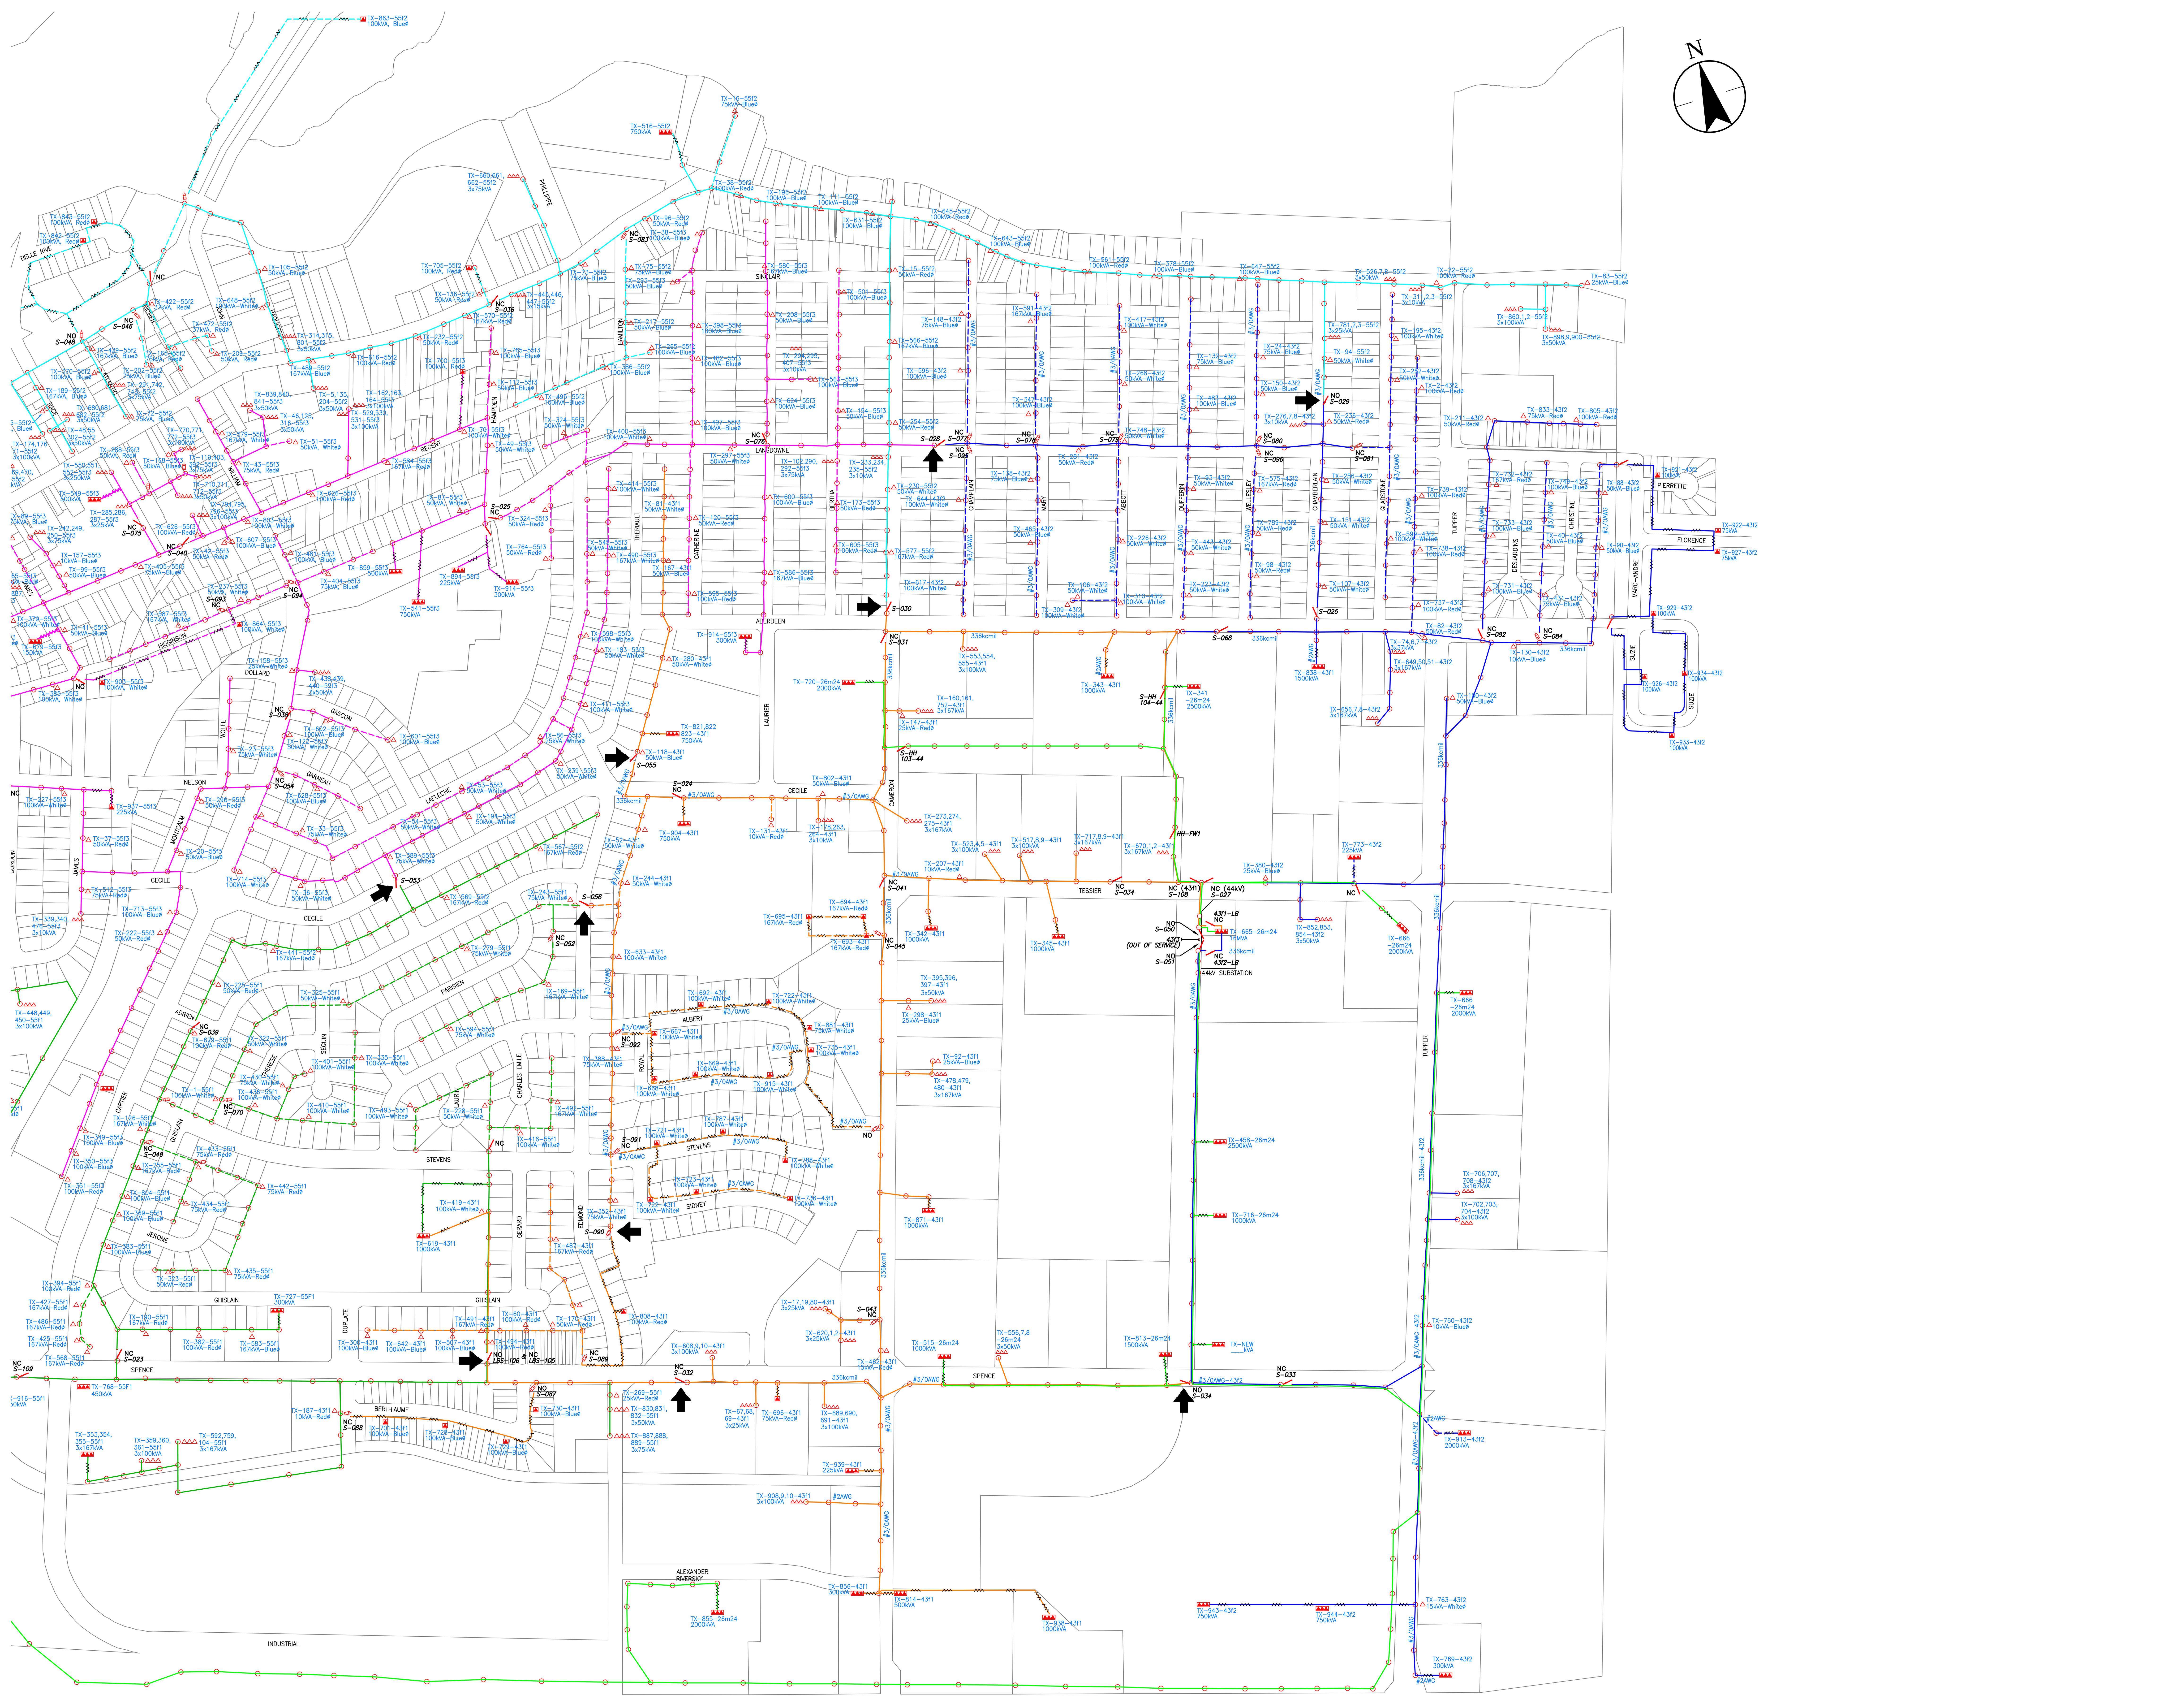

W:\active\163302381_HH_Distribution Map Updates(KB)\4_design\drawing\02381_E01~E03.dwg
2017/10/19 10:10 AM By: Yach, Brian

ORIGINAL SHEET - ISO A0

Stantec

STANTEC
400-1331 Clyde Avenue
Ottawa ON
Tel. 613.722.4420
www.stantec.com

Copyright Reserved

The Contractor shall verify and be responsible for all dimensions. DO NOT scale the drawing - any errors or omissions shall be reported to Stantec without delay.
The Copyrights to all designs and drawings are the property of Stantec. Reproduction or use for any purpose other than that authorized by Stantec is forbidden.

Consultants

Record Drawing

These drawings have been prepared based on information provided by others. Stantec has not verified the accuracy and/or completeness of this information and shall not be responsible for any errors or omissions which may be incorporated herein as a result.

LEGEND

- PADMOUNT TRANSFORMER
- OVERHEAD TRANSFORMER
- 3ø PADMOUNT TRANSFORMER
- 3ø OVERHEAD TRANSFORMERS
- HYDRO POLE
- UNDERGROUND CABLE
- 55F1 FEEDER – 3ø LINE
- 55F1 FEEDER – 1ø LINE
- 55F2 FEEDER – 3ø LINE
- 55F2 FEEDER – 1ø LINE
- 55F3 FEEDER – 3ø LINE
- 55F3 FEEDER – 1ø LINE
- 43F1 FEEDER – 3ø LINE
- 43F1 FEEDER – 1ø LINE
- 43F2 FEEDER – 3ø LINE
- 43F2 FEEDER – 1ø LINE
- 115kV LINE
- 44kV LINE
- FUSED CUTOUT
- SWITCH
- N.O. NORMALLY OPEN
- N.C. NORMALLY CLOSED
- OPEN POINT
- RECLOSER

Revision	By	Appd.	YY.MM.DD

Issued	By	Appd.	YY.MM.DD
B FOR FINAL	B.Y.	K.B.	17.10.19
A FOR REVIEW	B.Y.	K.B.	17.10.16

File Name: 02381_E01~E03.dwg	B.Y.	P.D.	K.B.	17.10.03
	Dwn.	Chkd.	Dsgn.	YY.MM.DD

Permit-Seal

Client/Project
HAWKESBURY HYDRO

DISTRIBUTION MAP UPDATES

850 Tupper Street, ON, K6A 3S7

Title
ELECTRICAL
PRIMARY DISTRIBUTION SYSTEM
PARTIAL MAP - EAST

Project No.	Scale	
163302381	1:3000	
Drawing No.	**Sheet**	**Revision**
E-2	2 of 3	0